

— LEGEND —

ITEM	NEW	EXISTING
CONTOURS	— 220 —	— 220 —
CATCH BASIN	■	□
STORM DRAIN PIPE	== SD ==	
ROOF DRAIN PIPE	== RD ==	
HEAD WALL	—	
CLEAN OUT	—	
MAN HOLE	○	○
RIP RAP	■	
RETAINING WALLS	—	
PROPERTY LINE	—	—
CONCRETE CURB & GUTTER	—	
WATER GATE VALVE	—	
WATER LINE	— W —	
FIRE HYDRANT	—	
SANITARY SEWER LINE	— SS —	
CONCRETE PAVING	■	

AS-BUILT

$$\begin{array}{r} 226.40 \\ + 32 \\ \hline 226.18 \end{array}$$

$$\begin{array}{r} 1/4 \\ 1/4 \\ 1/4 \\ \hline 3/4 \\ \hline 332 \end{array}$$


$$\begin{array}{r} 226.77 \\ - 32 \\ \hline 226.18 \end{array}$$

$$\begin{array}{r} 236 \\ 226.18 \\ \hline 9.82 \\ \hline 2 \end{array}$$

$$\frac{220}{4500}$$

$$\frac{24}{1/8}$$

<p>The State of South Carolina</p>	<p>AGENCY OR INSTITUTION</p> <p>DEPARTMENT OF MENTAL RETARDATION</p>	<p>PROFESSIONAL SEAL</p>	<p>A & E FIRM</p> <p>CARLISLE ASSOCIATES</p> <p>CARLISLE ASSOCIATES P.O. BOX 11528 COLUMBIA, S.C. 29211</p>	<p>SHEET TITLE</p> <p>INDEX PLAN</p>	<p>PROJECT TITLE</p> <p>CENTRAL OFFICE BUILDING PHASE II</p>

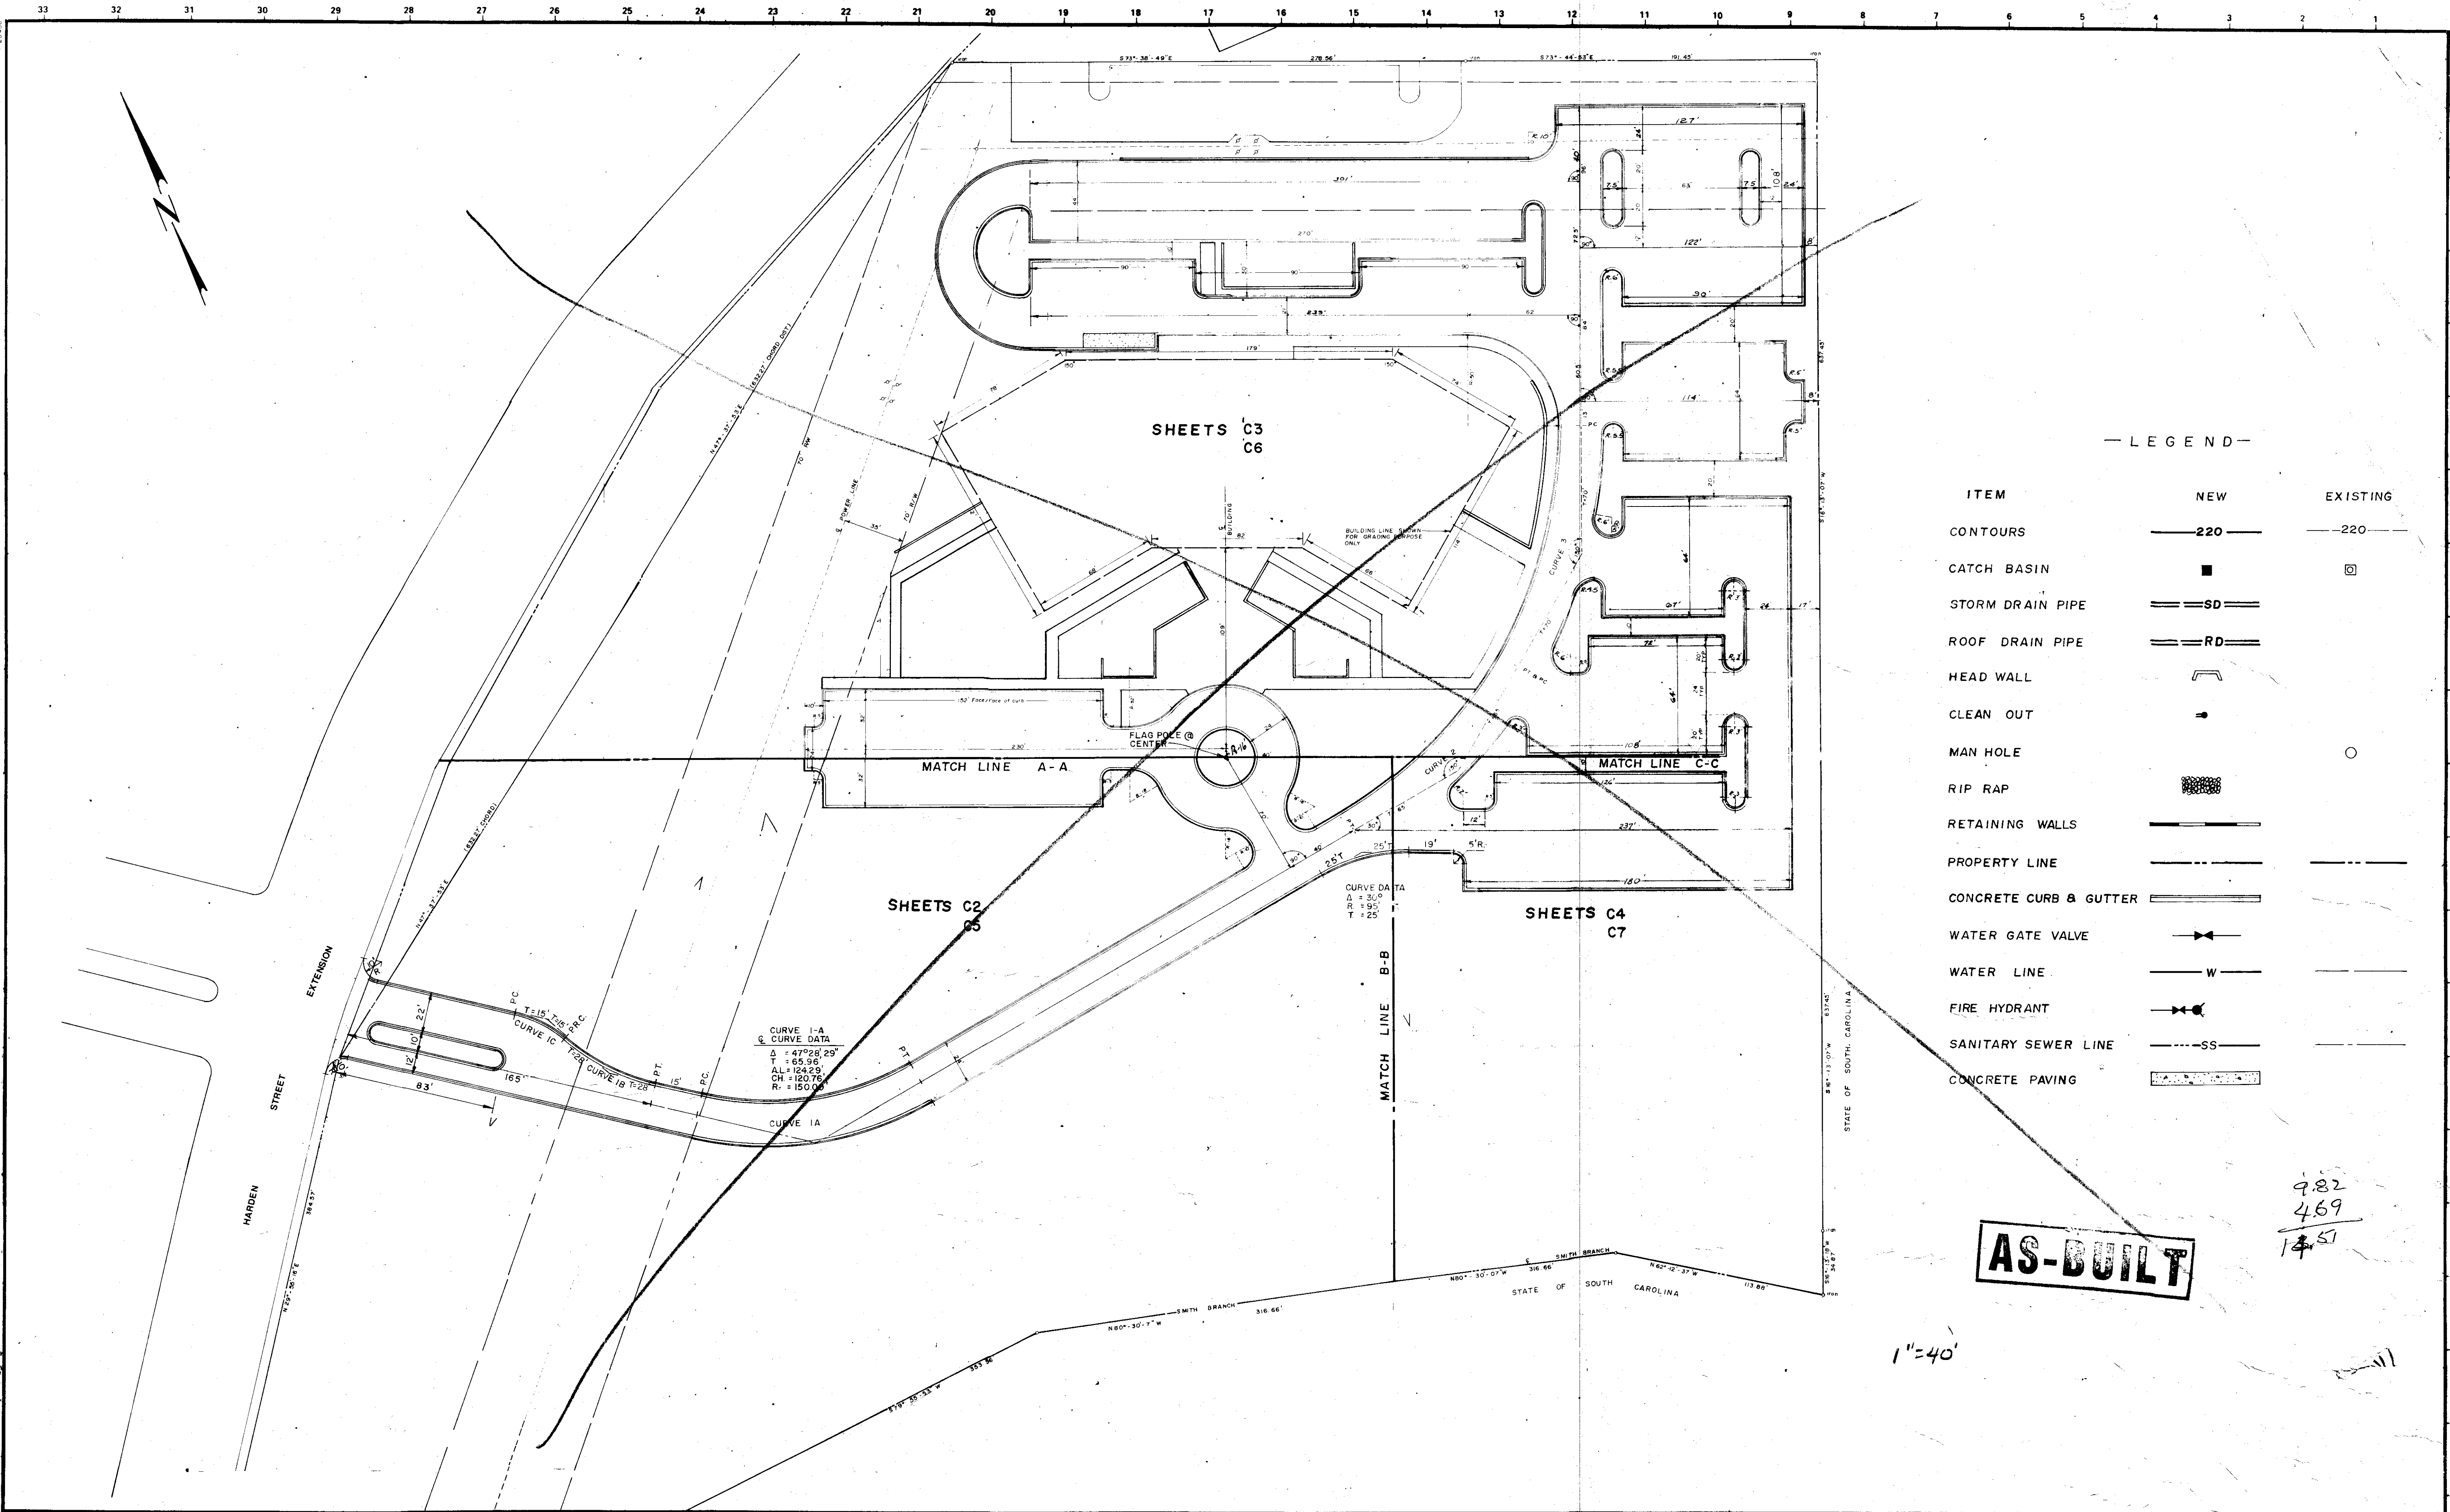

— LEGEND —

ITEM	NEW	EXISTING
CONTOURS	— 220 —	— 220 —
CATCH BASIN	■	□
STORM DRAIN PIPE	== SD ==	
ROOF DRAIN PIPE	== RD ==	
HEAD WALL	—	
CLEAN OUT	—	
MAN HOLE		○
RIP RAP	■	
RETAINING WALLS	—	
PROPERTY LINE	—	—
CONCRETE CURB & GUTTER	—	
WATER GATE VALVE	—	
WATER LINE	— W —	
FIRE HYDRANT	—	
SANITARY SEWER LINE	— SS —	
CONCRETE PAVING	■	



AS-BUILT

1"=40'

982
469
1451

<p>The State of South Carolina</p>	<p>DEPARTMENT OF MENTAL RETARDATION</p>		<table border="1"> <tr> <th>REVISION NO.</th> <th>DATE</th> <th>BY</th> <th>APP.</th> </tr> <tr> <td> </td> <td> </td> <td> </td> <td> </td> </tr> </table>	REVISION NO.	DATE	BY	APP.					<p>A & E FIRM</p> <p>CARLISLE ASSOCIATES P.O. BOX 11528 COLUMBIA, S.C. 29211</p>	<p>SHEET TITLE</p> <p>INDEX PLAN</p>	<p>PROJECT TITLE</p> <p>CENTRAL OFFICE BUILDING PHASE II</p>	
				REVISION NO.	DATE	BY	APP.								
<p>STATE PROJECT NO</p> <p>J16-8933</p>	<p>DRAWING NO</p> <p>S75-C1</p>	<p>SHEET</p> <p>C1 of C11</p>													
<p>DATE APRIL 1, 1988</p>				<p>DATE APRIL 1, 1988</p>	<p>DATE APRIL 1, 1988</p>	<p>DATE APRIL 1, 1988</p>	<p>DATE APRIL 1, 1988</p>								

MATCH LINE A-A SEE SHEET C3

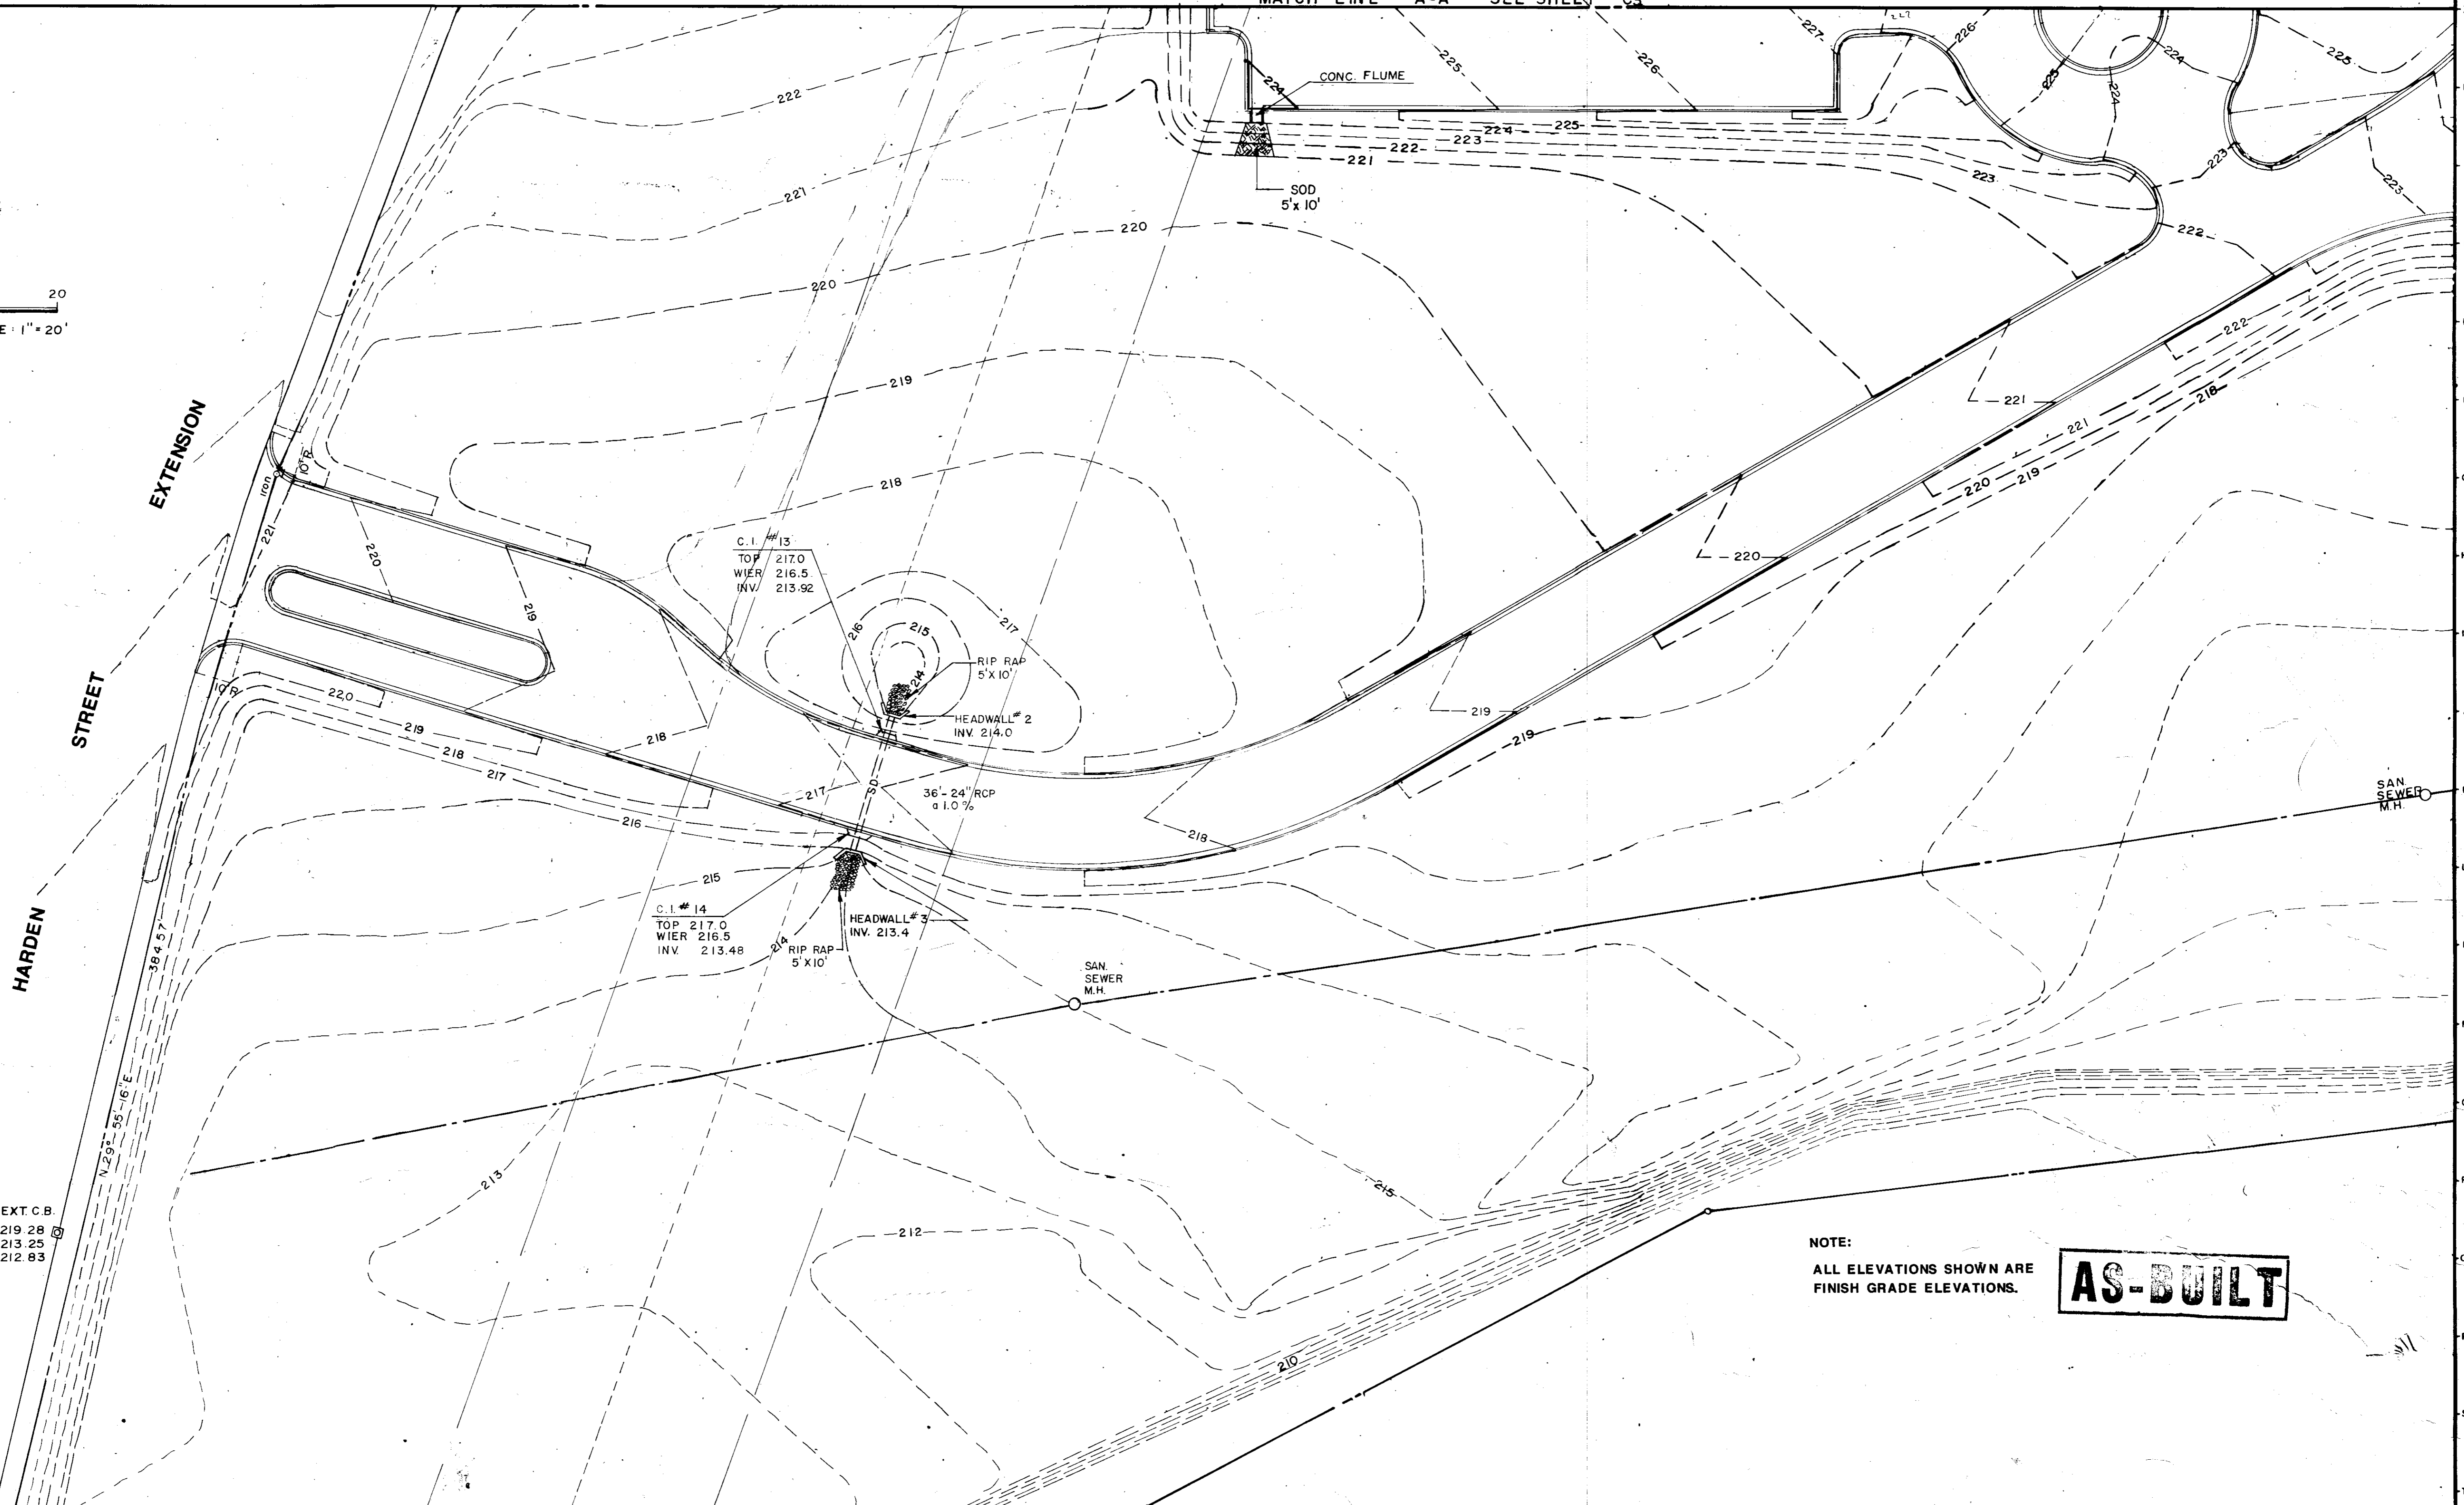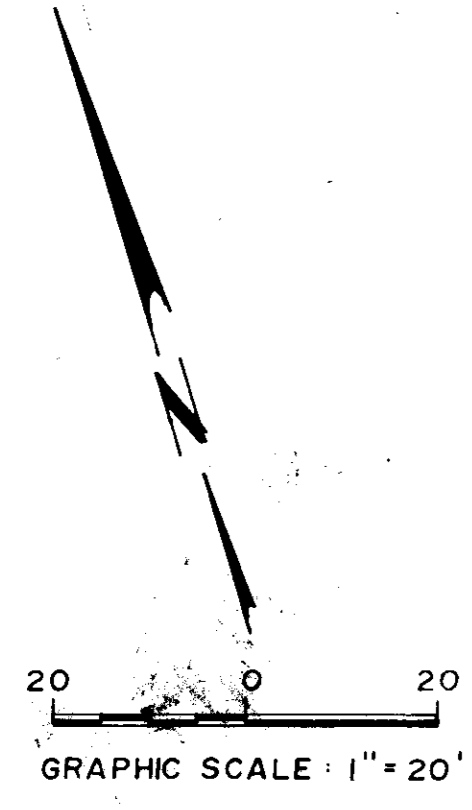





MATCH LINE B-B SEE SHEET C4


EXT. C.B.
TOP 219.28
INV. 213.25
INV. 212.83

NOTE:
ALL ELEVATIONS SHOWN ARE
FINISH GRADE ELEVATIONS.

AS-BUILT

 <p>The State of South Carolina</p>	 <p>DEPARTMENT OF MENTAL RETARDATION</p>		<table border="1"> <tr> <th>REVISION NO.</th> <th>DATE</th> <th>BY</th> <th>APP.</th> </tr> <tr> <td> </td> <td> </td> <td> </td> <td> </td> </tr> </table>	REVISION NO.	DATE	BY	APP.					 <p>CARLISLE ASSOCIATES P.O. BOX 11528 COLUMBIA, S.C. 29211</p>	<p>ASPHALT PAVEMENT & SIDEWALKS</p>	<p>AGENCY OR INSTITUTION</p>	<p>PROJECT TITLE</p>
				REVISION NO.	DATE	BY	APP.								
<p>STATE PROJECT NO. J16-8933</p>	<p>DRAWING NO. S75-C2</p>	<p>SHEET C2 OF C11</p>													

REPRODUCED FROM ORIGINALS

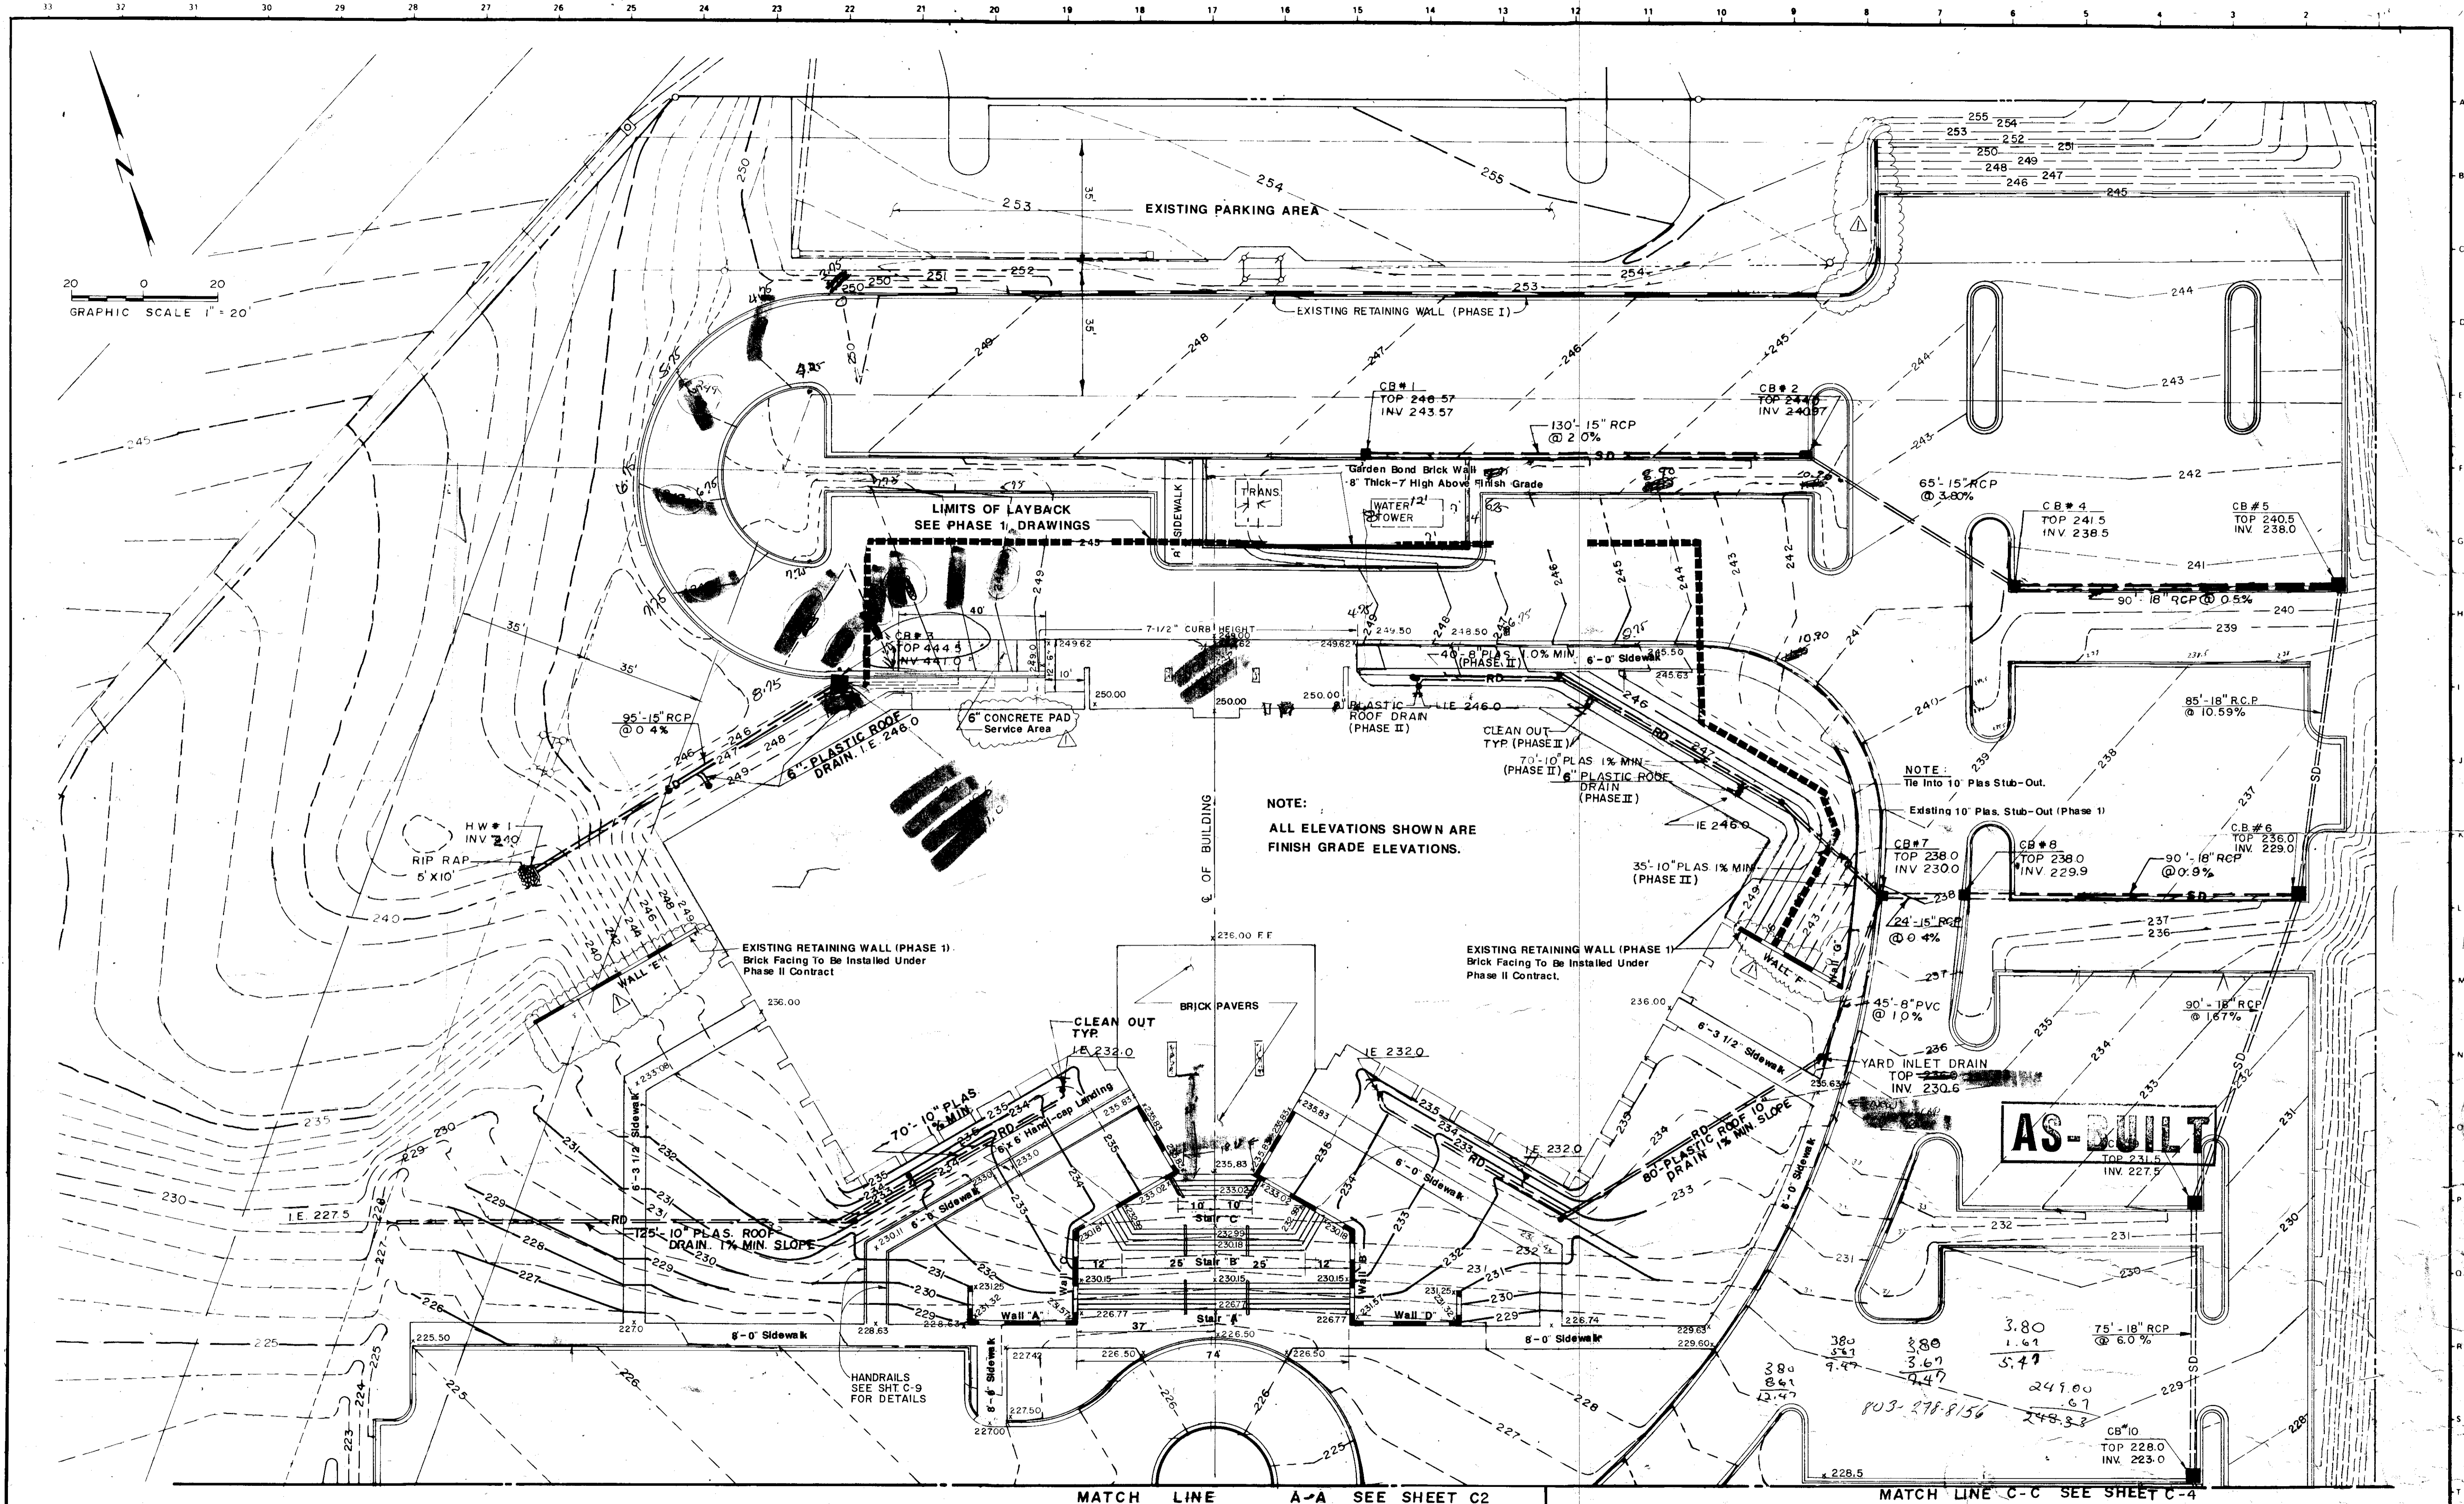

GRAPHIC SCALE 1" = 20'

NOTE:
ALL ELEVATIONS SHOWN ARE
FINISH GRADE ELEVATIONS.



NOTE:
Tie Into 10" Plus Stub-Out.

AS-BUILT

MATCH LINE A-A SEE SHEET C-2



MATCH LINE C-C SEE SHEET C-4

<p>The State of South Carolina</p>	<p>DEPARTMENT OF MENTAL RETARDATION</p>	<p>PROFESSIONAL SEAL</p>	<p>A & E FIRM</p>	<p>CARLISLE ASSOCIATES P.O. BOX 11528 COLUMBIA, S.C. 29211</p>	<p>SHEET TITLE</p> <p>ASPHALT PAVEMENT & SIDEWALKS</p>	<p>PROJECT TITLE</p> <p>CENTRAL OFFICE BUILDING PHASE II</p>										
						<p>AGENCY OR INSTITUTION</p>	<p>PROFESSIONAL SEAL</p>	<p>A & E FIRM</p>	<p>SHEET TITLE</p>	<p>PROJECT TITLE</p>						
<p>DIVISION</p>		<p>MISC. REVISIONS</p> <table border="1"> <tr> <th>NO.</th> <th>DATE</th> <th>BY</th> <th>APP.</th> </tr> <tr> <td>1-5-88</td> <td>TP</td> <td>TP</td> <td></td> </tr> </table>		NO.	DATE	BY	APP.	1-5-88	TP	TP		<p>A & E PROJECT NO S75</p>		<p>STATE PROJECT NO</p> <p>J16-8933</p>	<p>DRAWING NO</p> <p>S75-C3</p>	<p>SHEET</p> <p>C3 OF C11</p>
NO.	DATE	BY	APP.													
1-5-88	TP	TP														
				<p>DRAWN BY T.P.</p>	<p>CHECKED BY</p>	<p>FINAL APP J.F.</p>	<p>DATE</p> <p>APRIL 1, 1988</p>									

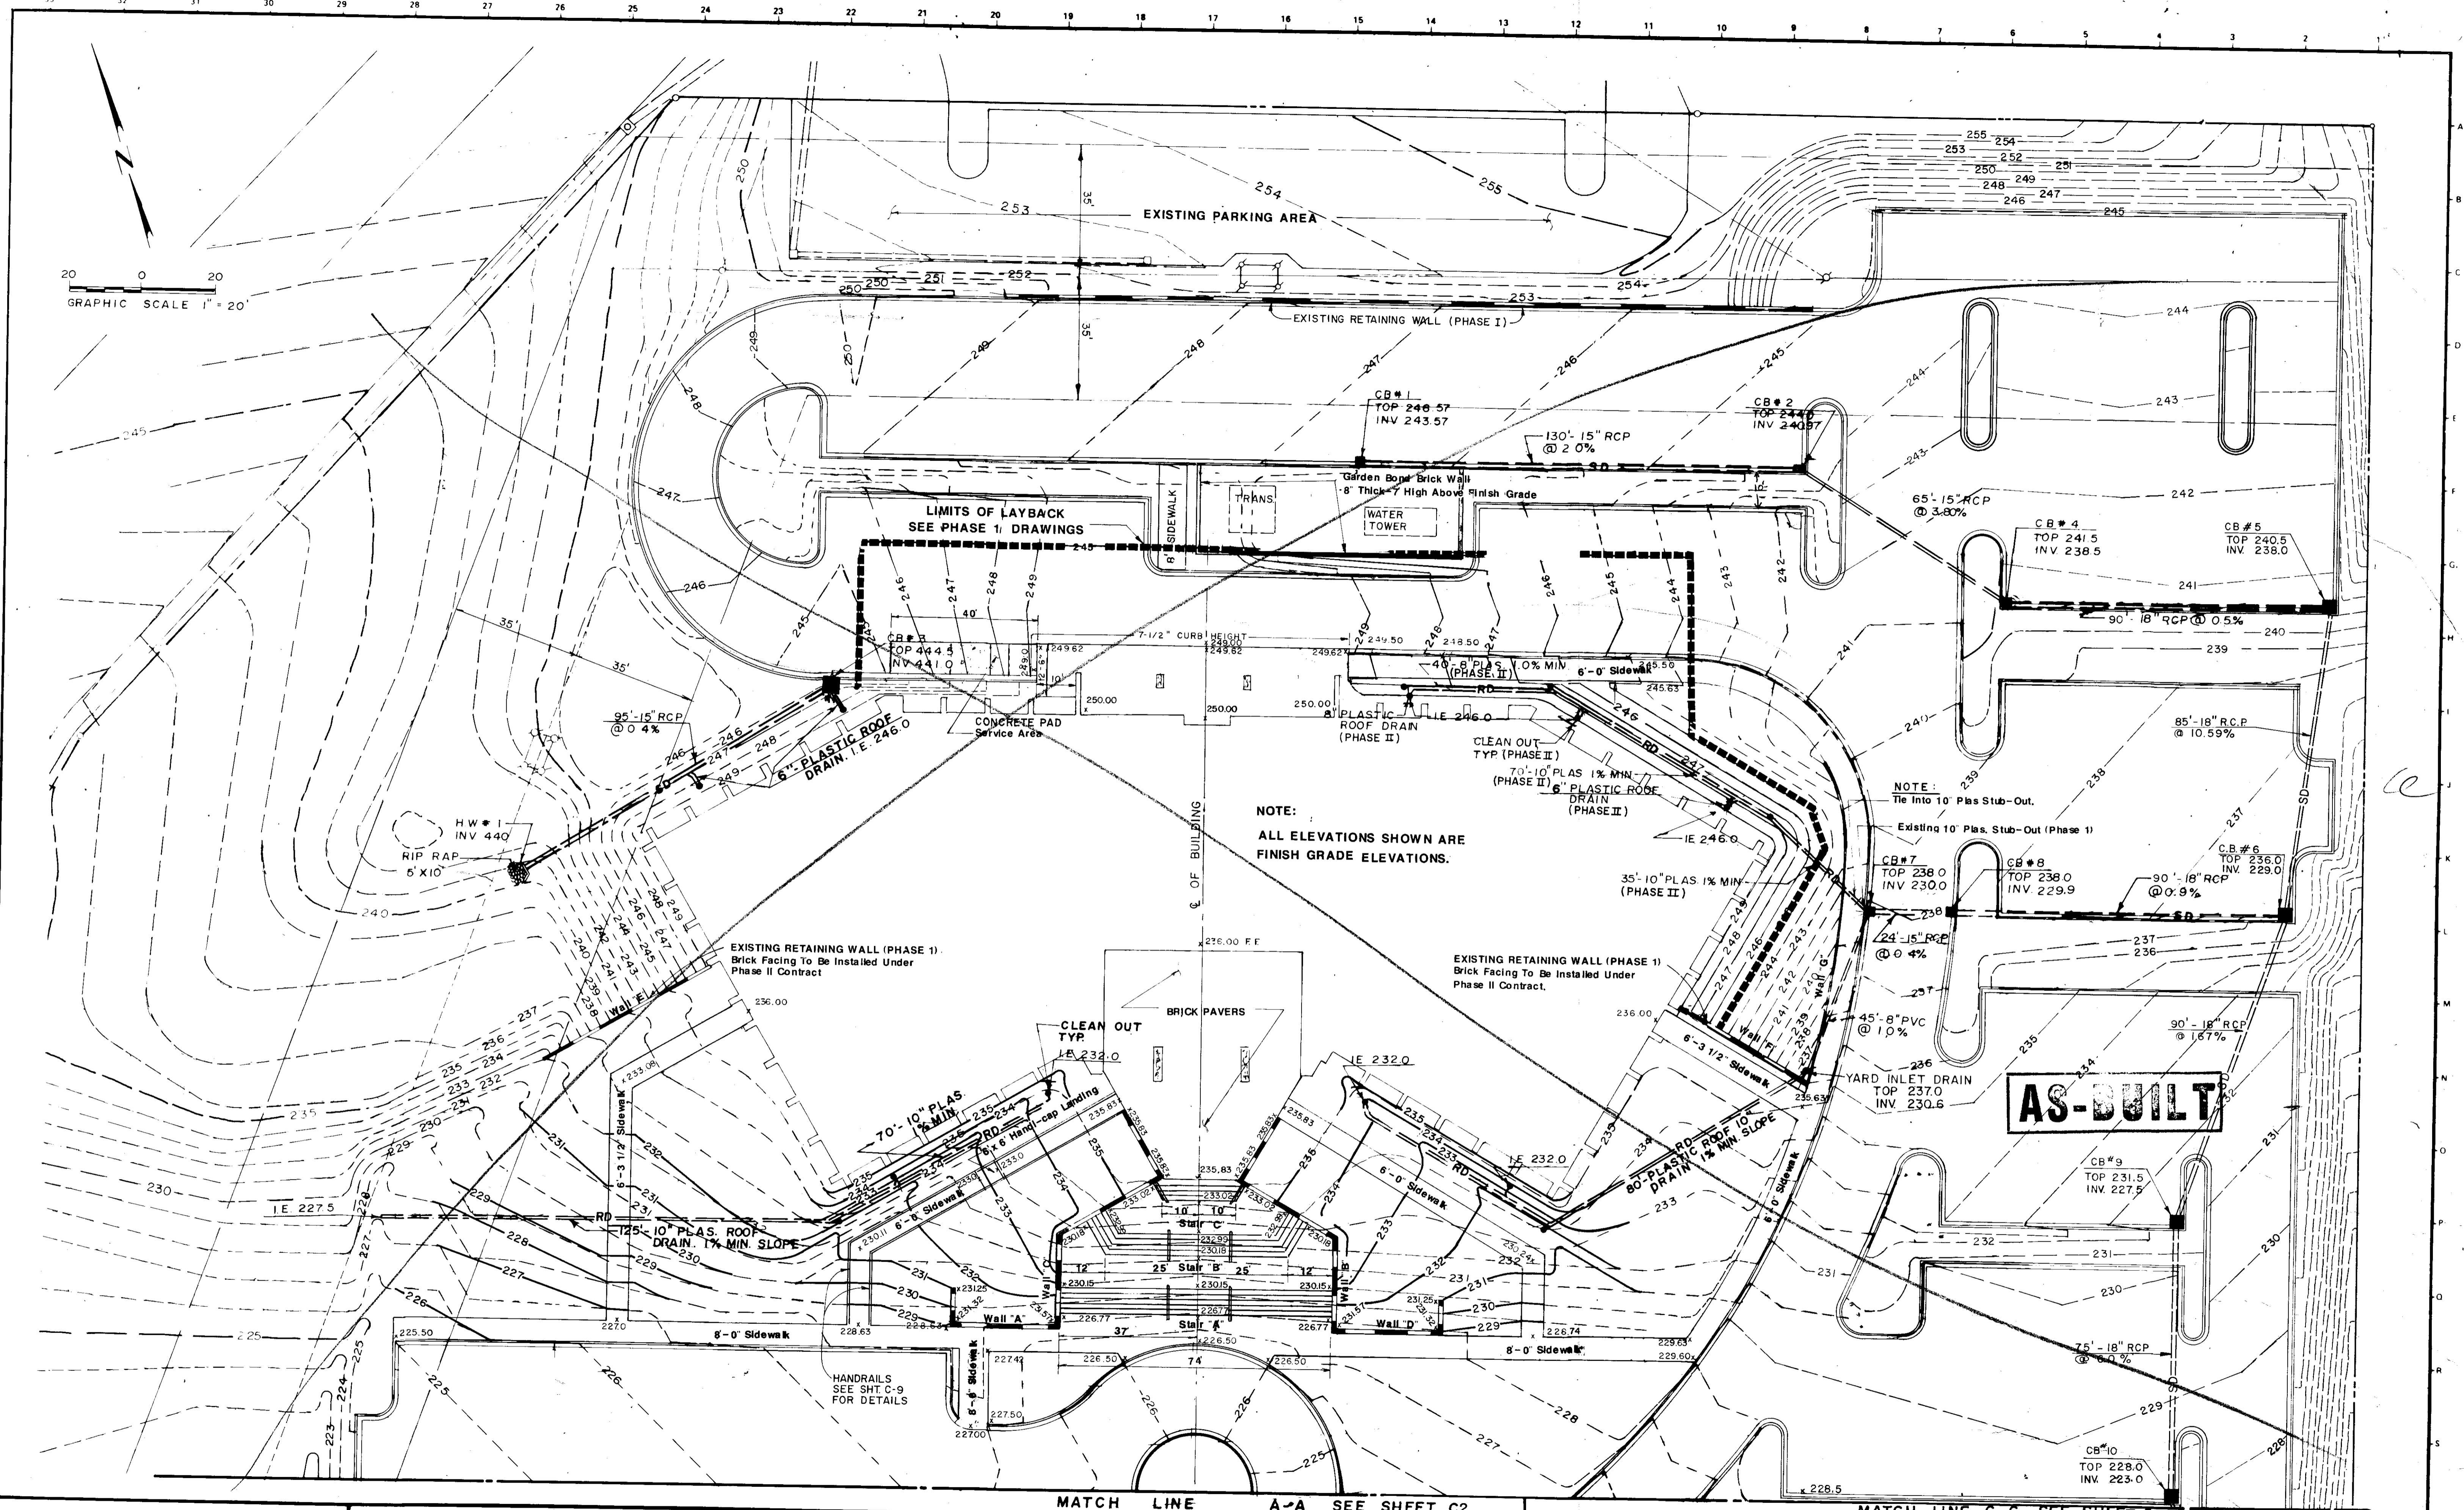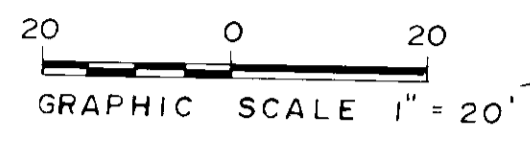




				CARLISLE ASSOCIATES P.O. BOX 11528 COLUMBIA, S.C. 29211	ASPHALT PAVEMENT & SIDEWALKS	PROJECT TITLE CENTRAL OFFICE BUILDING PHASE II				
						AGENCY OR INSTITUTION DEPARTMENT OF MENTAL RETARDATION	PROFESSIONAL SEAL JERRY F. FRIEDNER	SHEET TITLE ASPHALT PAVEMENT & SIDEWALKS	PROJECT TITLE CENTRAL OFFICE BUILDING PHASE II	
DIVISION		REVISION NO. DATE BY APP		A & E PROJECT NO. S75	DRAWN BY T.P. CHECKED BY FINAL APP J.F.	STATE PROJECT NO. J16-8933	DRAWING NO. S75-C3	SHEET NO. C3	DATE APRIL 1, 1988	SHEET NO. C11

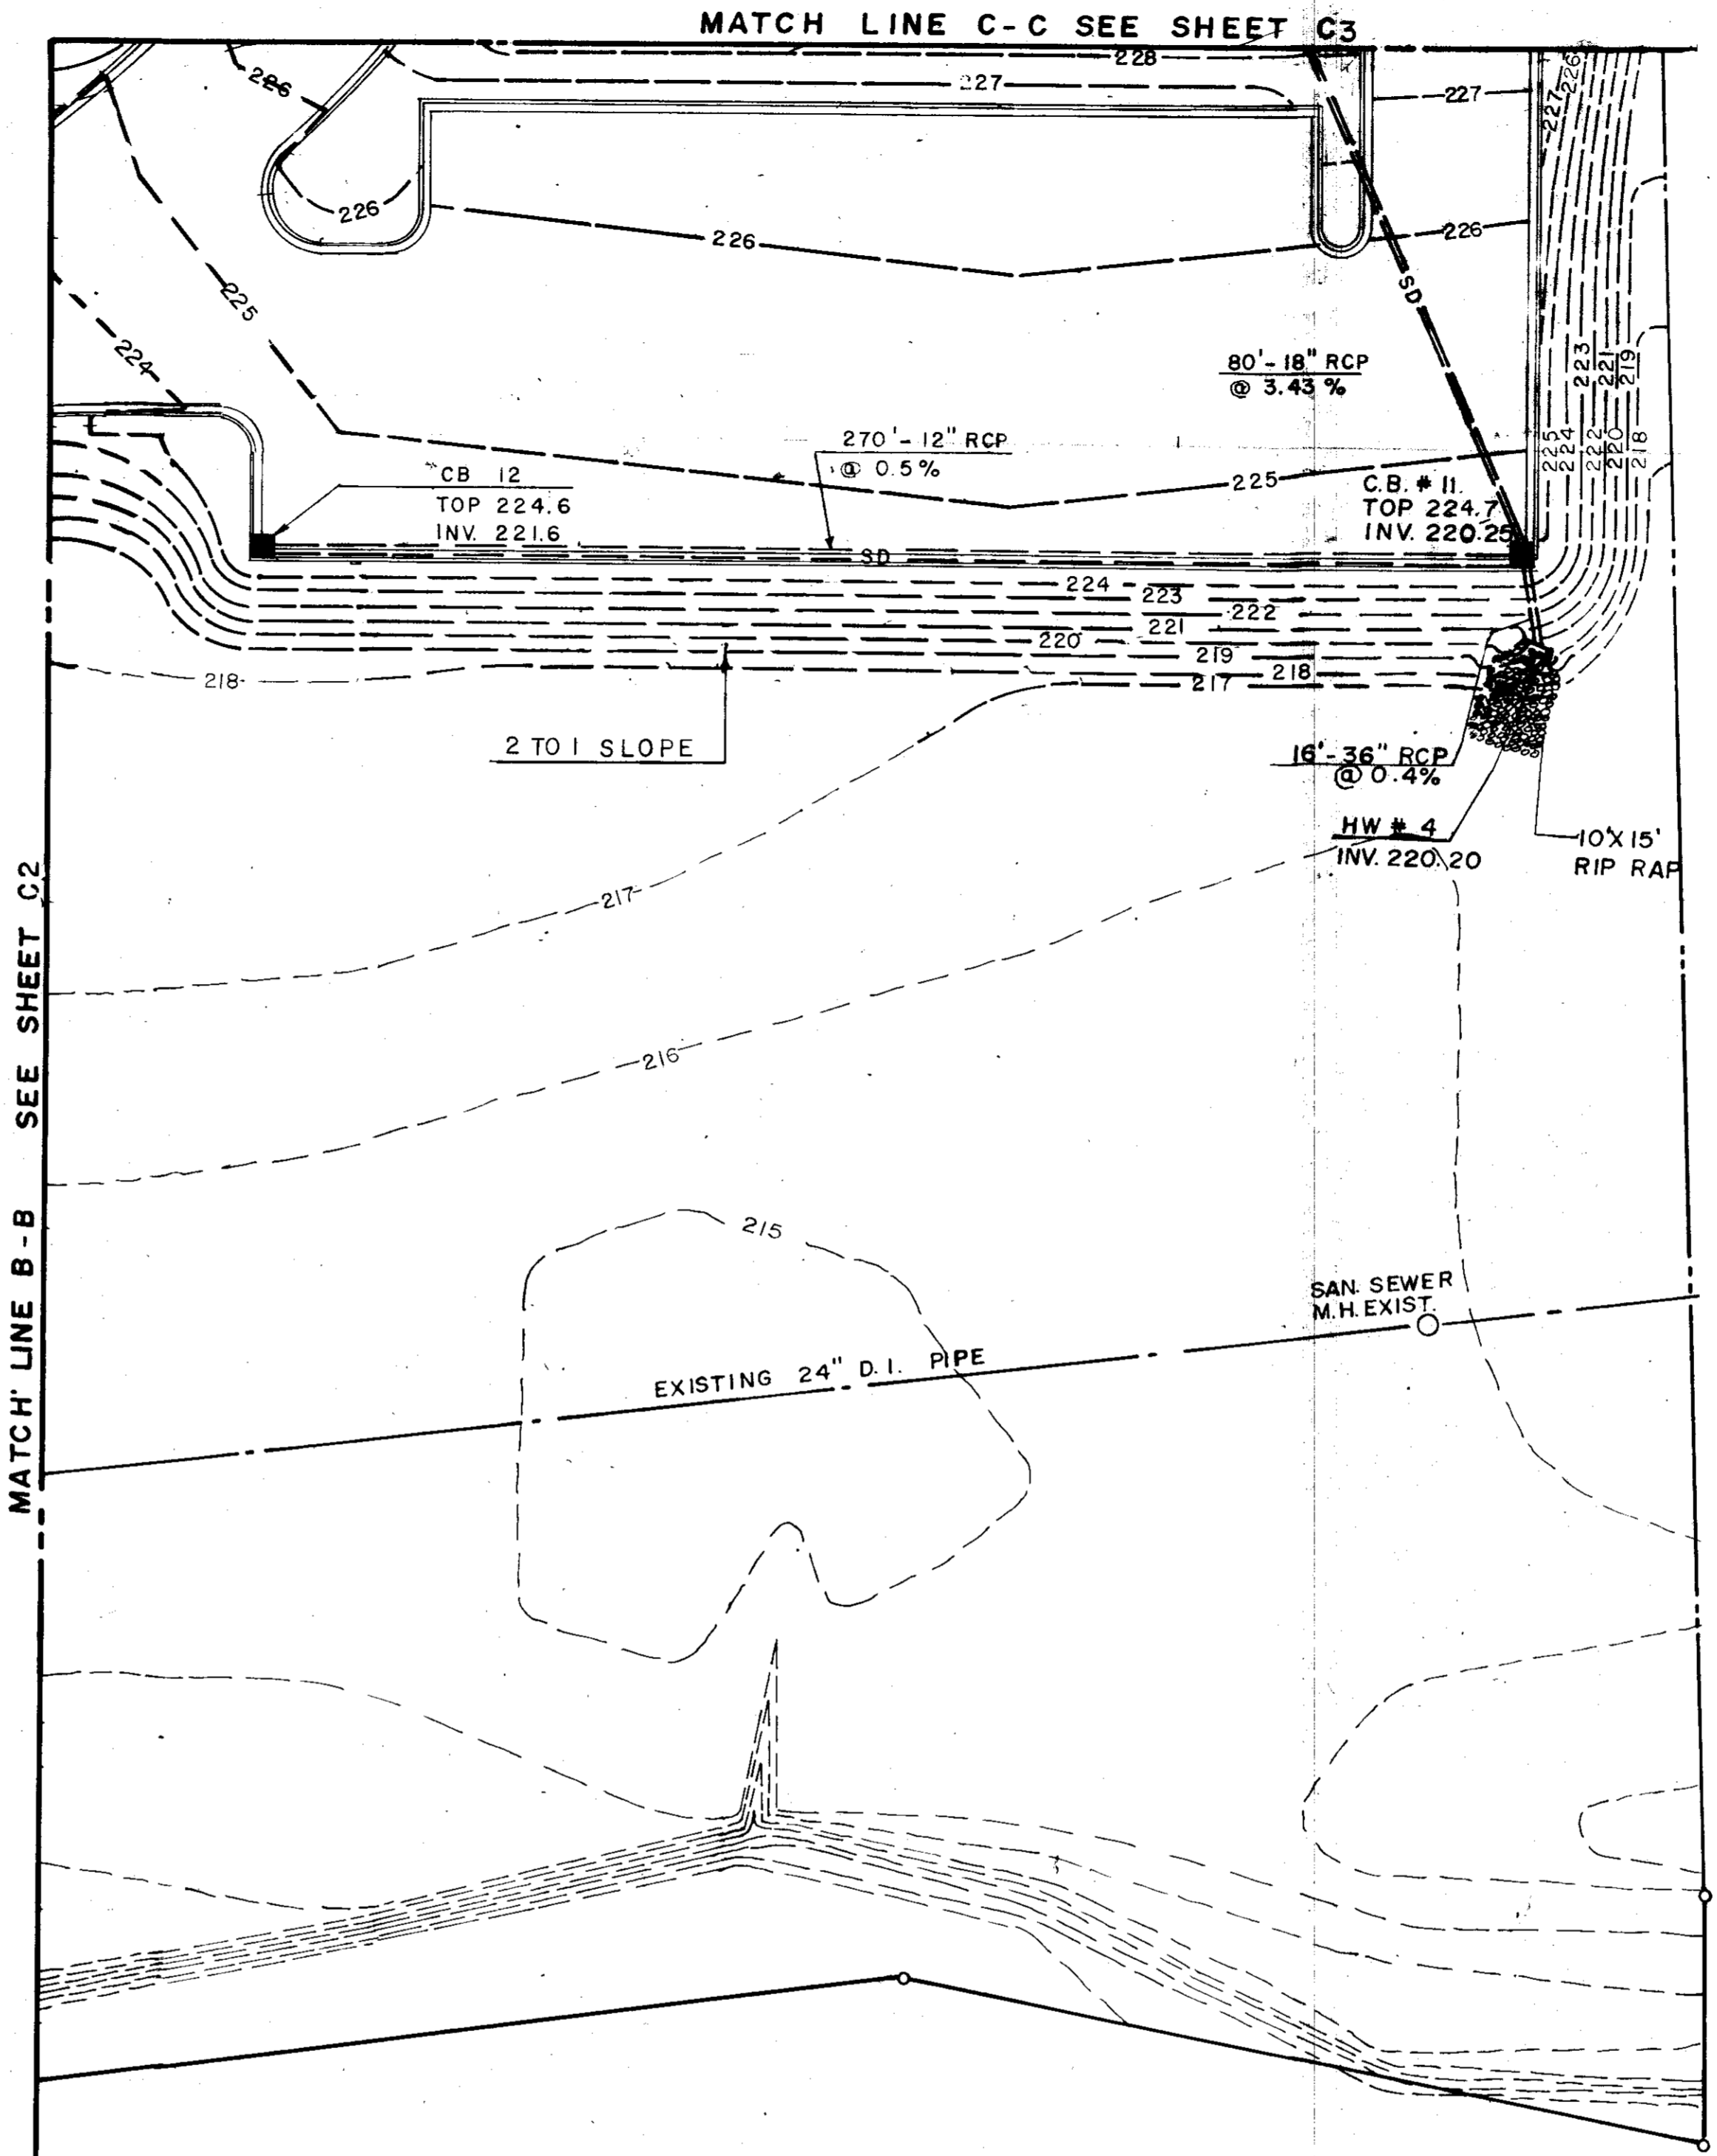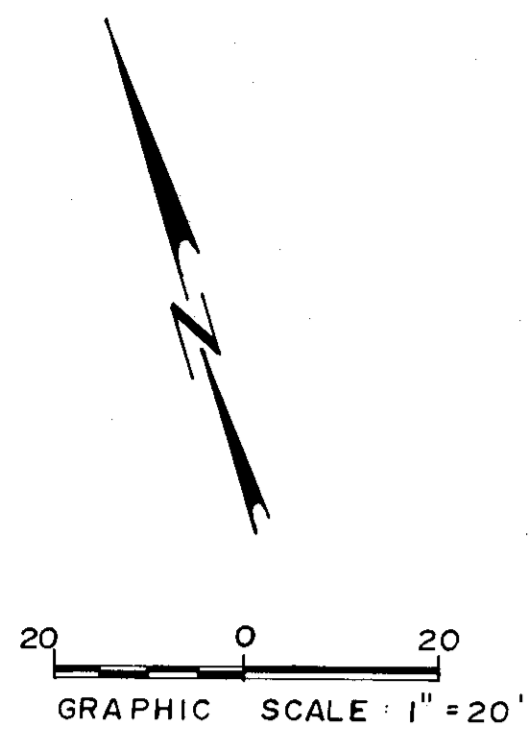33 32 31 30 29 28 27 26 25 24 23 22 21 20 19 18 17 16 15 14 13 12 11 10 9 8 7 6 5 4 3 2 1



AS-BUILT

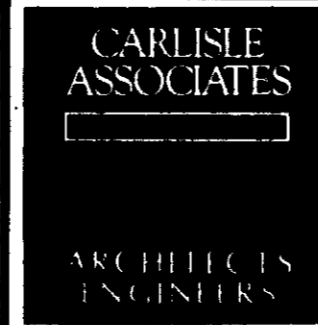 <p>The State of South Carolina</p>	<p>AGENCY OR INSTITUTION</p> <p>DEPARTMENT OF MENTAL RETARDATION</p> <p>DIVISION</p>	<p>PROFESSIONAL SEAL</p> 	<table border="1"> <tr> <th>REVISION NO.</th> <th>DATE</th> <th>BY</th> <th>APP.</th> </tr> <tr> <td> </td> <td> </td> <td> </td> <td> </td> </tr> </table>	REVISION NO.	DATE	BY	APP.					<p>A & E FIRM</p>  <p>CARLISLE ASSOCIATES P.O. BOX 11528 COLUMBIA, S.C. 29211</p> <p>A & E PROJECT NO. S75</p>	<p>SHEET TITLE</p> <p>ASPHALT PAVEMENT & SIDEWALKS</p>	<p>PROJECT TITLE</p> <p>CENTRAL OFFICE BUILDING PHASE II</p>		
				REVISION NO.	DATE	BY	APP.									
<p>STATE PROJECT NO.</p> <p>J16-8933</p>	<p>DRAWING NO.</p> <p>S75-CA</p> <p>DATE APRIL 1, 1988</p>	<p>SHEET</p> <p>04 OF C11</p>														